


BUILDING SECTION A-A
SCALE: 1/4" = 1'-0"

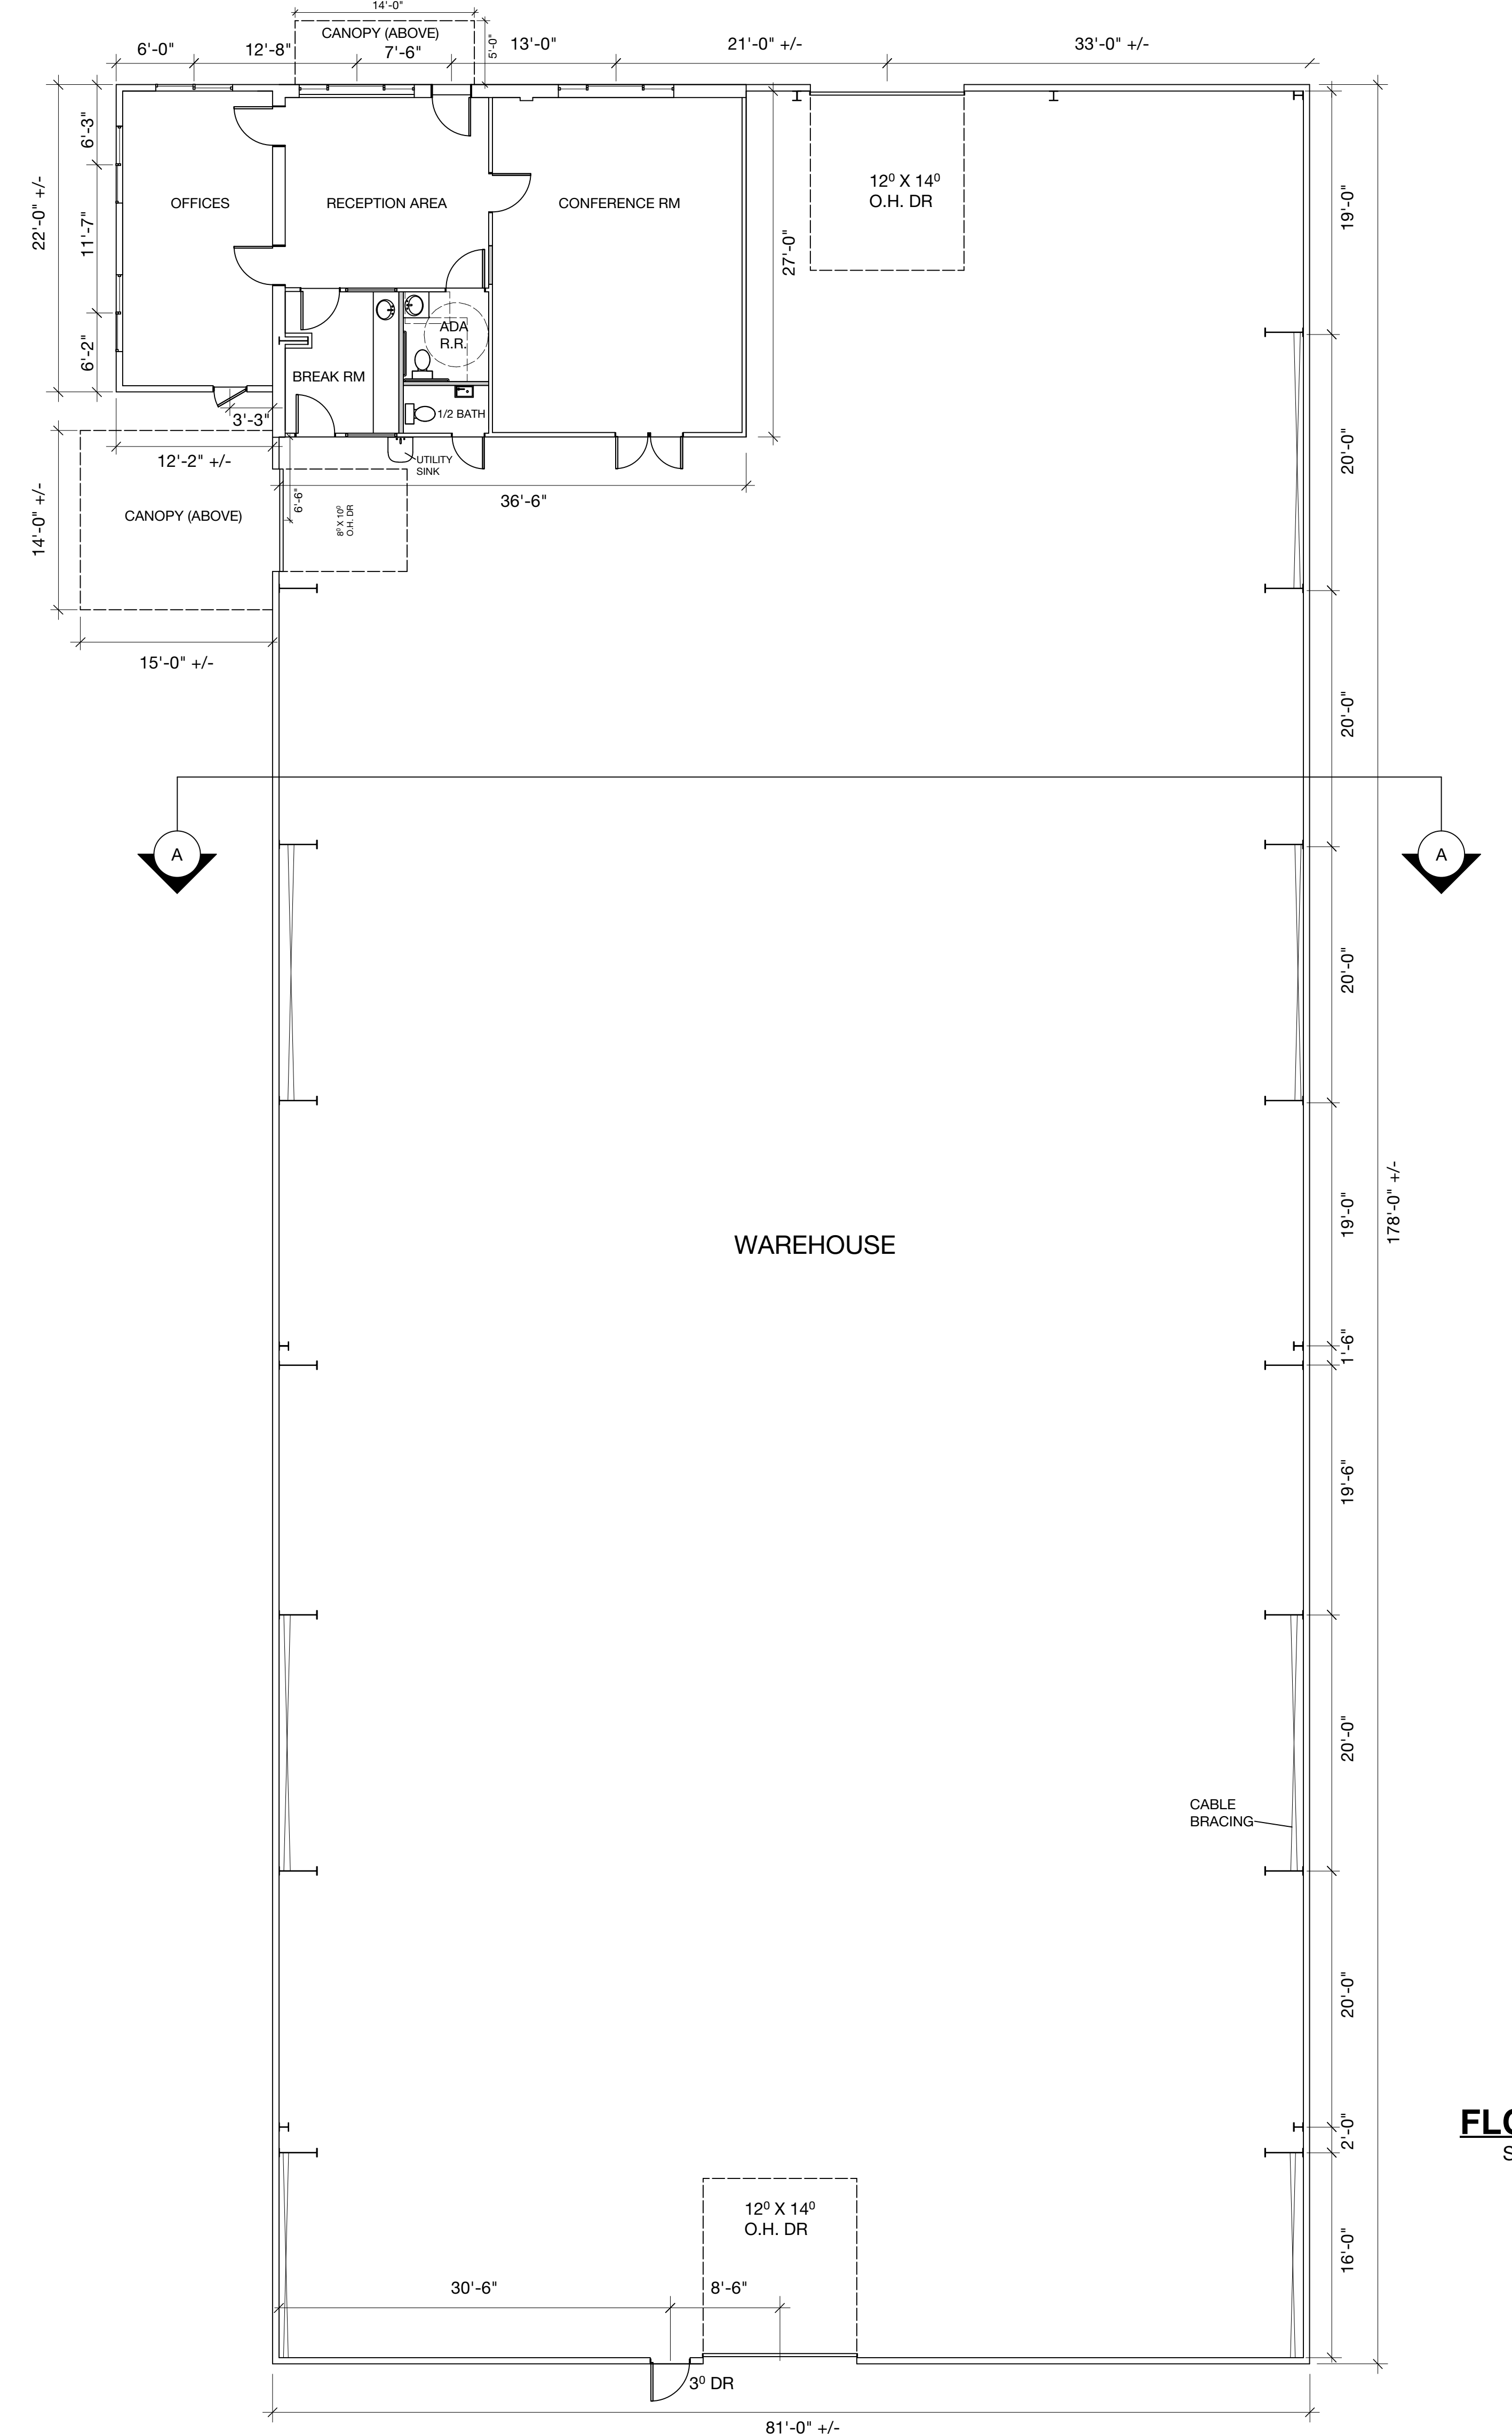

FLOOR PLAN
SCALE: 1/4" = 1'-0"

FOR JFJ COMPANY
1750 Moore St.

DOUGLAS LANDSEM ARCHITECT AIA
LICENSED ARCHITECT IN WASHINGTON, IDAHO, ALASKA, HAWAII
1407 NORTH FOREST, BELLINGHAM, WA 98225
www.landsemarchitect.com
360.733.2466
dla@landsemarch.net